
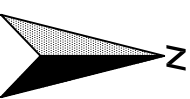


ALBERTA LAND SURVEYOR'S REAL PROPERTY REPORT

*NOTE:
ALL CANTILEVERS ARE SHOWN
THUS-----AND ARE 0.61M
UNLESS OTHERWISE NOTED
EAVES ARE MEASURED TO THE
LINE OF FASCIA
ALL EAVES ON CANTILEVERS AND/OR
BAYS ARE 0M UNLESS NOTED OTHERWISE
ALL WINDOW WELLS ARE 178X0.55
UNLESS NOTED OTHERWISE
LINES OUTSIDE OF PROPERTY
ARE NOT TO SCALE
UNLESS OTHERWISE NOTED
FOUND NO MARKS AT ALL PROPERTY CORNERS

ABBREVIATIONS AND DEFINITIONS
THAT MAY OR MAY NOT BE USED IN THE RPR
M/R/W MUTUAL ACCESS RIGHT OF WAY
M/W MAINTENANCE RIGHT OF WAY
B/O/C BACK OF CURB
B/O/W BACK OF WALK
M.O.W. MIDDLE OF WALK
T.O.C. TOP OF CURB
F.d. I FOUND IRON POST
F.d. II FOUND IRON MARK
F.d. III FOUND IRON BAR
F.d. IV FOUND IRON BAR
F.d. V FOUND IRON BAR
D.H. DRILL HOLE FOR WAY
U.R./W UTILITY RIGHT OF WAY
R. RADIUS OF CURVE AND/OR RADIAL
L. LENGTH OF ARC
MINUTE
SECOND
CANTILEVER
CANTILEVER
P.O.I. POINT OF INTERSECTION
U/R UNREGISTERED
B/C BEGINNING OF CURVE
F.d. I FOUND IRON POST
H.V.A.C. HEATING VENTILATION AIR CONDITIONING
W.W. WINDOW WELL

THE FOLLOWING ITEMS MAY NOT
BE SHOWN ON THIS RPR
-MOVABLE SHEDS THAT ARE LESS THAN 10M2
-RETAINING WALLS OR INTERIOR FENCES (DOGS RUNS)
-HOLDING NOT DERIVE THE PROPERTY LINE
-HOLDING NOT DERIVE THE PROPERTY LINE
-STEPS AND STAIRS
-ITEMS THAT IN THE OPINION OF THE SURVEYOR
DO NOT SUBSTANTIALLY INCREASE THE VALUE
OF THE PROPERTY

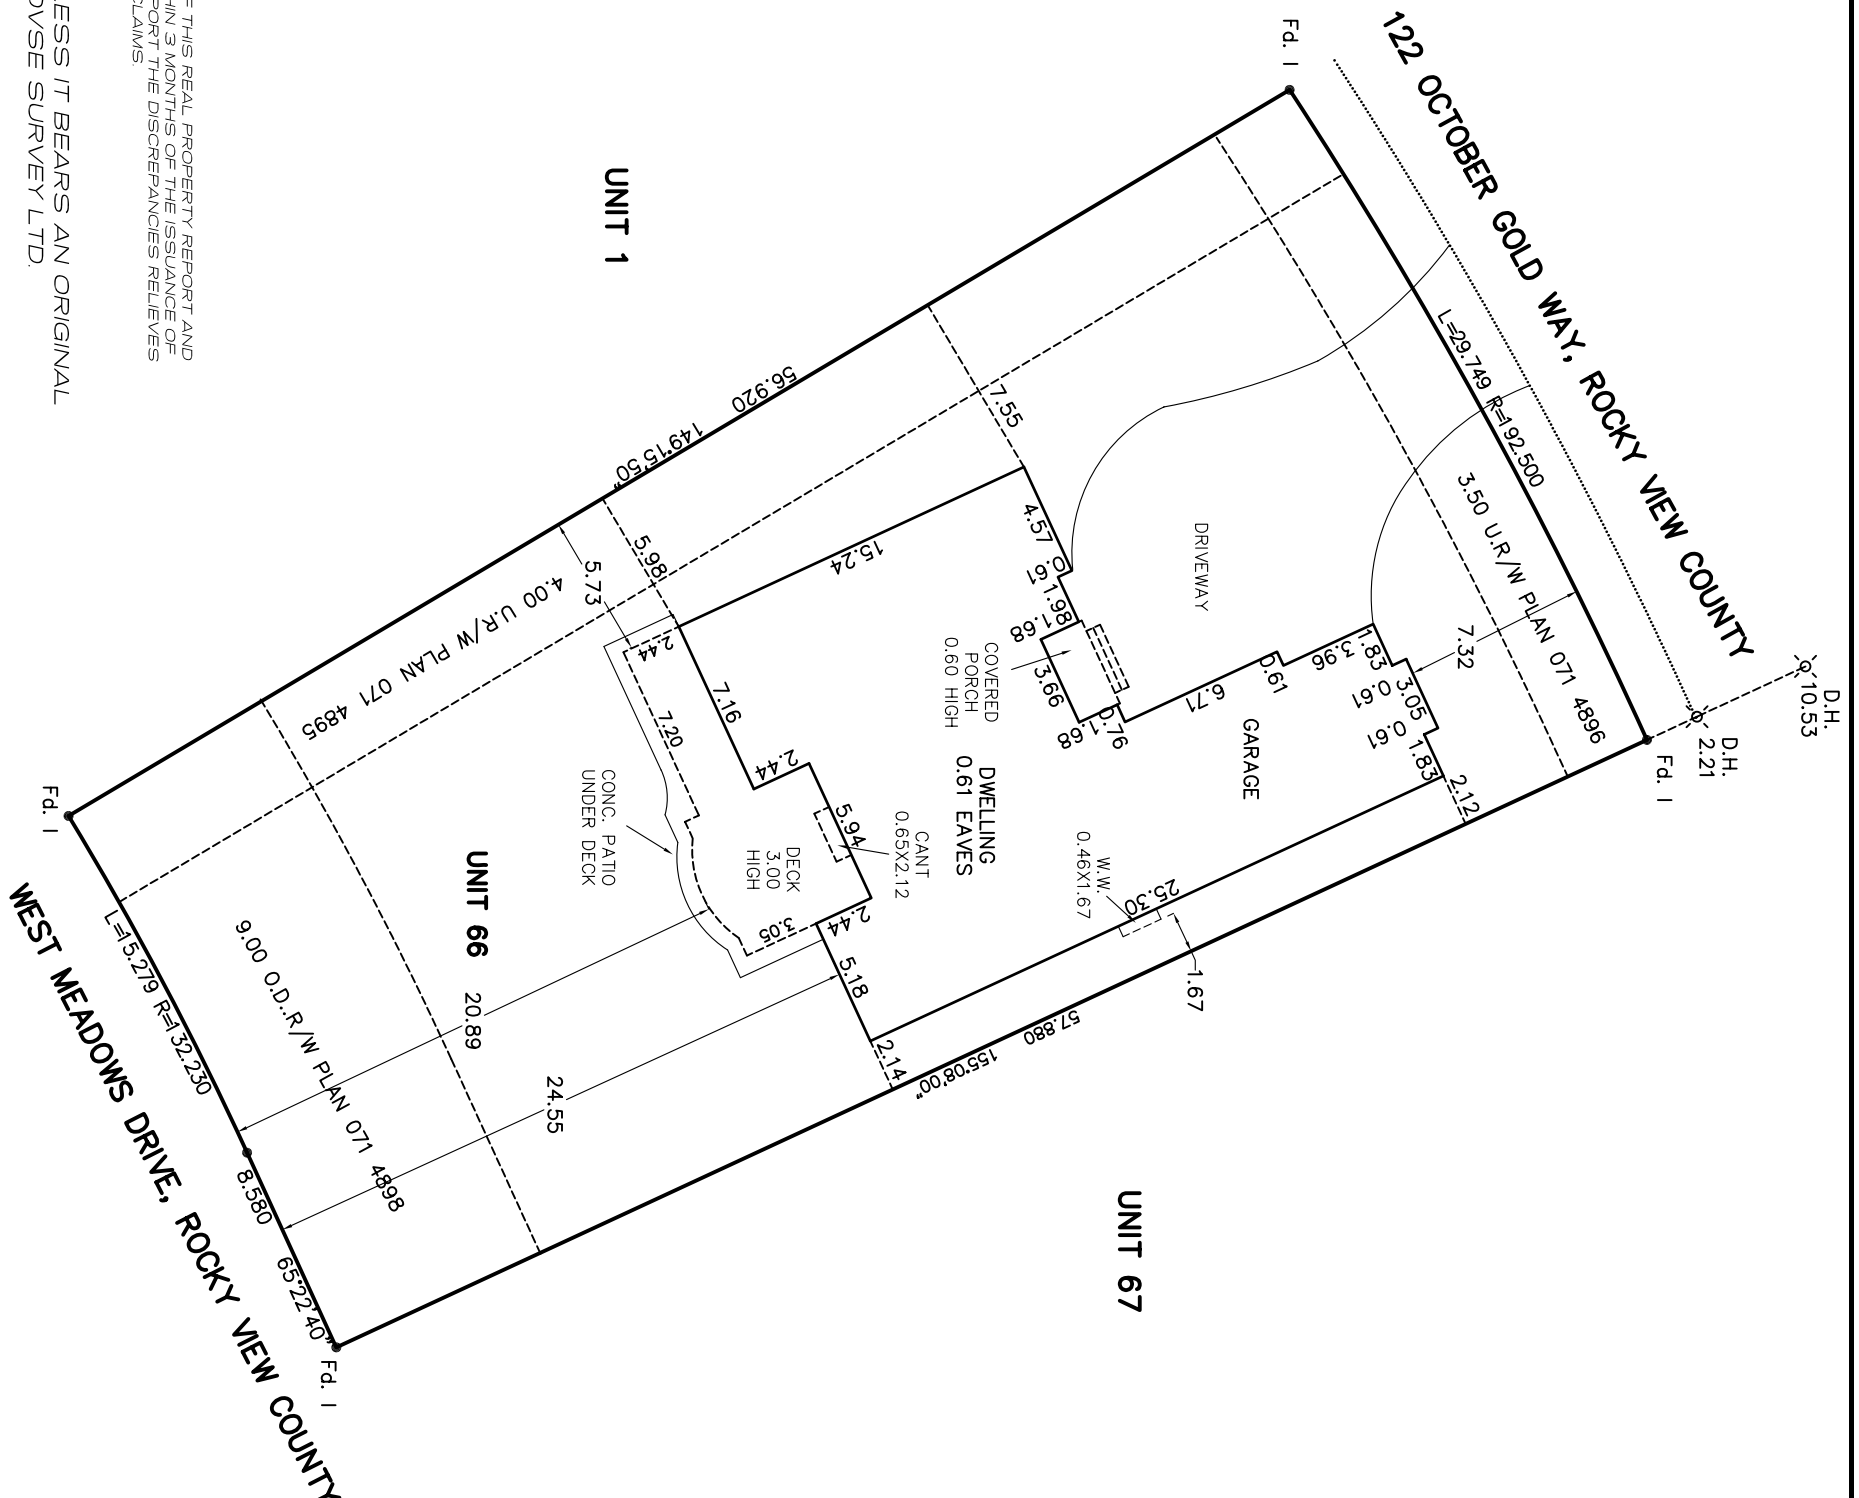

PLAN 071 4894
UNIT 66 AND 82 UNDIVIDED ONE TEN THOUSANDTH
SHARES IN THE COMMON PROPERTY EXCEPTING THEREOUT
ALL MINES AND MINERALS
122 OCTOBER GOLD WAY
ROCKY VIEW COUNTY, ALBERTA
CLIENT DIANNE ST. MARS

Certification:

I hereby certify that this Report, Plan and related survey was prepared and performed under my personal supervision and in accordance with the Manual of Standard Practice of the Alberta Land Surveyors' Association and supplements thereto. Accordingly within those standards and as of the date of this report:

1. the Plan illustrates the boundaries of the Property, the improvements as defined in part D, Section 85 of the Alberta Land Surveyors Association's Manual of Standard Practice, registered easements, and rights-of-way, affecting the extent of title to the Property;
2. the improvements are entirely within the boundaries of the Property; except NIL
3. no visible encroachments exist on the Property from any improvements situated on an adjoining property; except NIL
4. no visible encroachments exist on registered easements or rights-of-way affecting the extent of Property; except NIL

Purpose: This report and related plan have been prepared for the benefit of the property owner, subsequent owners and any of their agents for the purpose of (a) land conveyance support of a subdivision application, a mortgage application, a submitted to the municipality for a compliance certificate, etc) Copying is permitted only for the benefit of these parties and only if the plan remains attached. Where applicable, registered easements and utility rights-of-way affecting the extent of the property have been shown on the attached plan. Unless shown otherwise, property corner markers have not been placed during the Survey for this Report. This plan should not be used to establish boundaries because of the risk of misinterpretation or measurement error by the user. The information shown on this Real Property Report reflects the status of this Property as of the date of survey only. Users are encouraged to have the Real Property Report updated for future requirements. Dated at City of Calgary, Alberta This 16th day of SEPTEMBER 2009

Louis Wang, ALBERTA LAND SURVEYOR
© copyright LOVSE SURVEYS LTD

LEGEND:

Found Iron Posts are shown thus: F.d. I ●
Found Iron Bars are shown thus: F.d. II ♦
All distances are in metres and decimals thereof.
Distances shown on curve boundaries are Arc distances.
Fences are shown thus: -o-o-o-o-o-o-o-o-o-o- and are deemed to be on property line if within +/- 0.2m
The dimensions shown related to perpendicular distances from property boundaries to foundation walls

NOTE:

Survey completed on SEPTEMBER 14th, 2009
The information is based on a title search on SEPTEMBER 15th, 2009 and subject to:
921 326 045 R.C.
071 496 417 CAVEAT RE: DEVELOPMENT AGREEMENT
071 496 418 CAVEAT RE: DEFERRED SERVICES AGREEMENT
071 496 420 U.R./W PLAN 071 4895
071 496 421 U.R./W PLAN 071 4895
071 496 425 U.R./W
071 496 428 AGREEMENT RE: EASEMENT AND R.C.
071 496 429 AGREEMENT RE: EASEMENT AND R.C.
071 496 430 AGREEMENT RE: EASEMENT AND R.C.

NOT WITHSTANDING ITEMS 2&4 OF THE CERTIFICATION, THE DRIVEWAY AND/OR WALKWAY IS NORMALLY PERMITTED TO ENCROACH ONTO UTILITIES RIGHT OF WAYS AND/OR OUTSIDE THE PROPERTY LINE WITHOUT AN ENCROACHMENT AGREEMENT

Drawn by: JL Scale: 1:300 METRIC FILE NO: 0805227

LOVSE SURVEYS LTD.
consulting engineers • land surveyors

#240, 251 MIDPARK BOULEVARD SE
CALGARY, ALBERTA, T2X 1S3
PHONE 403-254-2010 FAX 403-254-1723
WWW.LOVSESURVEYS.COM

THE OWNER IS RESPONSIBLE FOR THE REVIEW OF THIS REAL PROPERTY REPORT AND REPORT ANY DISCREPANCIES OR OMISSIONS WITHIN 3 MONTHS OF THE ISSUANCE OF THIS REPORT TO THE SURVEYOR. FAILURE TO REPORT THE DISCREPANCIES RELIEVES LOVE SURVEYS OF ANY FUTURE LIABILITIES OR CLAIMS.

THIS DOCUMENT IS NOT VALID UNLESS IT BEARS AN ORIGINAL SIGNATURE (IN BLUE INK) AND A LOVE SURVEY LTD. PERMIT STAMP (IN RED INK).